

APPLICATION FOR PERMIT

SEWER—SEWAGE DISPOSAL

1

COUNTY OF LOS ANGELES
DEPARTMENT OF COUNTY ENGINEER
BUILDING AND SAFETY DIVISION
JOHN A. LAMBIE, County Engineer
WILLIAM A. JENSEN, Sup't of Building

FOR APPLICANT TO FILL IN

LEGAL DESCRIPTION	LOT NO. <u>3</u>	
BLOCK	TRACT <u>8323</u>	
SIZE OF LOT	NO. OF BLDGS. NOW ON LOT <u>50-200</u> <u>1</u>	
USE OF BUILDINGS	<u>Dwelling</u>	
CONTRACTOR	<u>Owner</u>	
ADDRESS	<u>1868 La Merced</u>	
CITY	<u>San. San Gabriel</u>	
REGISTRATION NO.	STATE COUNTY	
NO. <u>1</u>	DESCRIPTION OF WORK	FEE
	HOUSE SEWER CONNECTING TO PUBLIC SEWER	@ \$3.00 <u>3 00</u>
	SEPTIC TANK, SEEPAGE PIT OR PITS AND/OR DRAINFIELD	@ \$3.00
	OVERFLOW SEEPAGE PIT, DRAINFIELD EXTN., CESSPOOL, DRYWELL	@ \$2.00
	HOUSE SEWER CONNECTING TO PRIVATE DISPOSAL SYSTEM	@ \$1.00
	CONNECT ADDITIONAL BLDG. OR WORK TO HOUSE SEWER	@ \$1.00
	ALTER, REPAIR OR ABANDON HOUSE SEWER OR DISPOSAL SYSTEM	@ \$1.00

OWNER'S AUTHORIZATION	PERMIT \$ <u>2 00</u>
	TOTAL FEE <u>5 00</u>

I HAVE AT THIS DATE A CONTRACT WITH THE HEREIN NAMED CONTRACTOR TO CONNECT THE ABOVE DESCRIBED EXISTING DWELLING TO THE PUBLIC SEWER.

SIGNED THIS 22 DAY OF May 1961

OWNER OR OWNERS AGENT H. H. Haushbueger

ADDRESS Same

I HEREBY ACKNOWLEDGE THAT I HAVE READ THIS APPLICATION AND STATE THAT THE ABOVE IS CORRECT AND AGREE TO COMPLY WITH ALL COUNTY ORDINANCES AND STATE LAWS REGULATING PLUMBING AND SEWERS.

I HEREBY CERTIFY THAT I AM PROPERLY REGISTERED AND/OR LICENSED AS REQUIRED BY LOS ANGELES COUNTY AND STATE OF CALIFORNIA OR THAT I AM THE LEGAL OWNER OF THE ABOVE DESCRIBED RESIDENTIAL PROPERTY.

SIGNATURE OF PERMITTEE H. H. Haushbueger

BUILDING ADDRESS	<u>7868 La Merced</u>
LOCALITY	<u>So. San Gabriel</u>
NEAREST CROSS ST.	<u>Riding</u>
OWNER	<u>H. H. Haushbueger</u>
MAIL ADDRESS	<u>7868 La Merced</u>
CITY	<u>So. San Gabriel</u>

DISTRICT NO.	GROUP	MAP	PG	PROCESSED BY
<u>5</u>	<u>I</u>	<u>BF</u>	<u>-140</u>	<u>LeLorte</u>

CONNECTION DATA

STATION	<u>1+15.5</u>	DEPTH	<u>9'</u>
MANHOLE REFERENCE	<u>1.2' W. of</u>	UPPER	

Y.	TYPE OF CONNECTION CURB	P.L.	LENGTH FROM M.L. TO P.L.
			<u>approx. 30'</u>

CO. IMP. NO.	<u>1406</u>	P. C. NO.	
		JOB NO.	

TRUNK PERMIT NO.	ROAD PERMIT NO.
------------------	-----------------

STATE ENCROACHMENT PERMIT NO.

INDUSTRIAL WASTE APPROVAL

CHARGES

CONNECTION CHARGE FEE

REIMBURSEMENT FEE

APPROVALS	DATE	INSPECTOR'S SIGNATURE
NEW HOUSE SEWER	<u>5-31-61</u>	<u>Samsey</u>
CONNECT ADDITIONAL BUILDING OR WORK		
SEPTIC TANK, SEEP. PIT(S) AND/OR DRAINFIELD		
CESSPOOL <input type="checkbox"/> DRYWELL <input type="checkbox"/>		
ALTER, REPAIR, SEWER OR SEWAGE DISPOSAL SYSTEM		
DISCONNECT PLUG AND ABANDON HOUSE SEWER		
BACKFILL SEPTIC TANKS <input type="checkbox"/> SEEP. PIT(S) <input type="checkbox"/> CESSPOOLS <input type="checkbox"/>		

VALIDATION

CK. M. O. CASH

ROBERT A. WOOD
SUPERVISING MECHANICAL ENGINEER

U674343 MAY 22 1961

5.00


Rausch

INSPECTOR COPY

FOR DEPARTMENT USE

REQUIRED INFORMATION

1. INDICATE ALL BUILDINGS ON PROPERTY.
2. INDICATE AND DIMENSION SEWAGE DISPOSAL SYSTEM WITH TIE DISTANCES TO BUILDINGS AND PROPERTY LINES.
3. INDICATE SIZE OF SEPTIC TANK—DEPTH OF SEEPAGE PIT(S)—SIZE OF CESSPOOL(S).
4. INDICATE NORTH DIRECTION ON PLOT.
5. INDICATE BOTH STREETS IF CORNER.

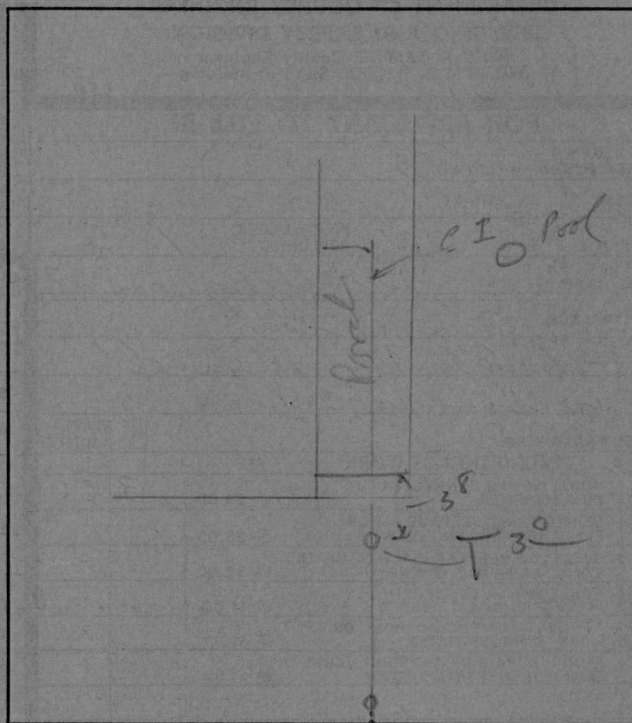

ST. ALLEY R/W

FIELD NOTES

Cesspool to be filled within 14 days
 Ramsey 5-31-61
 Cesspool Filled Ramsey 11-8-61